




A SECTION A

EXTERNAL LINE OF GLAZING

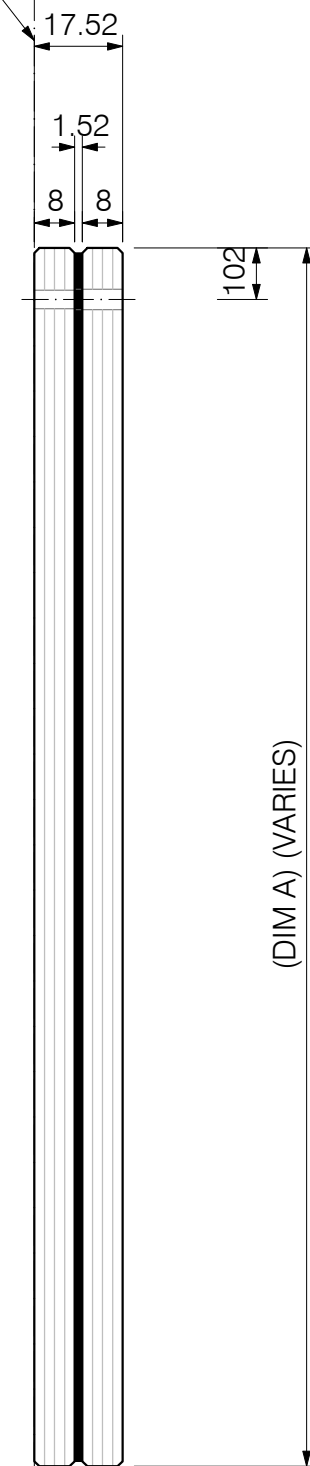

SECTION B

— EXTERNAL LINE OF GLAZING

[illegible]

C	19.06.2013	AS BUILT	T.HO
B	28.09.2012	GLASS HOLE SIZES	T.HO
A	25.09.2012		T.HO
ISSUE	DATE	DESCRIPTION OF CHANGE	BY

SOUTH STAIR
LEGION HOUSE 161
CASTLEREAGH ST

SCALE:	JOB No:	DRAWING No:	ISSUE:
N.T.S		GL-S-50	B